




© ROBERT PASHUK ARCHITECTURE INC. ALL RIGHTS RESERVED. This document is protected by Copyright Laws and may not be reproduced in any manner, or for any purpose, except with the written permission of the copyright holder.

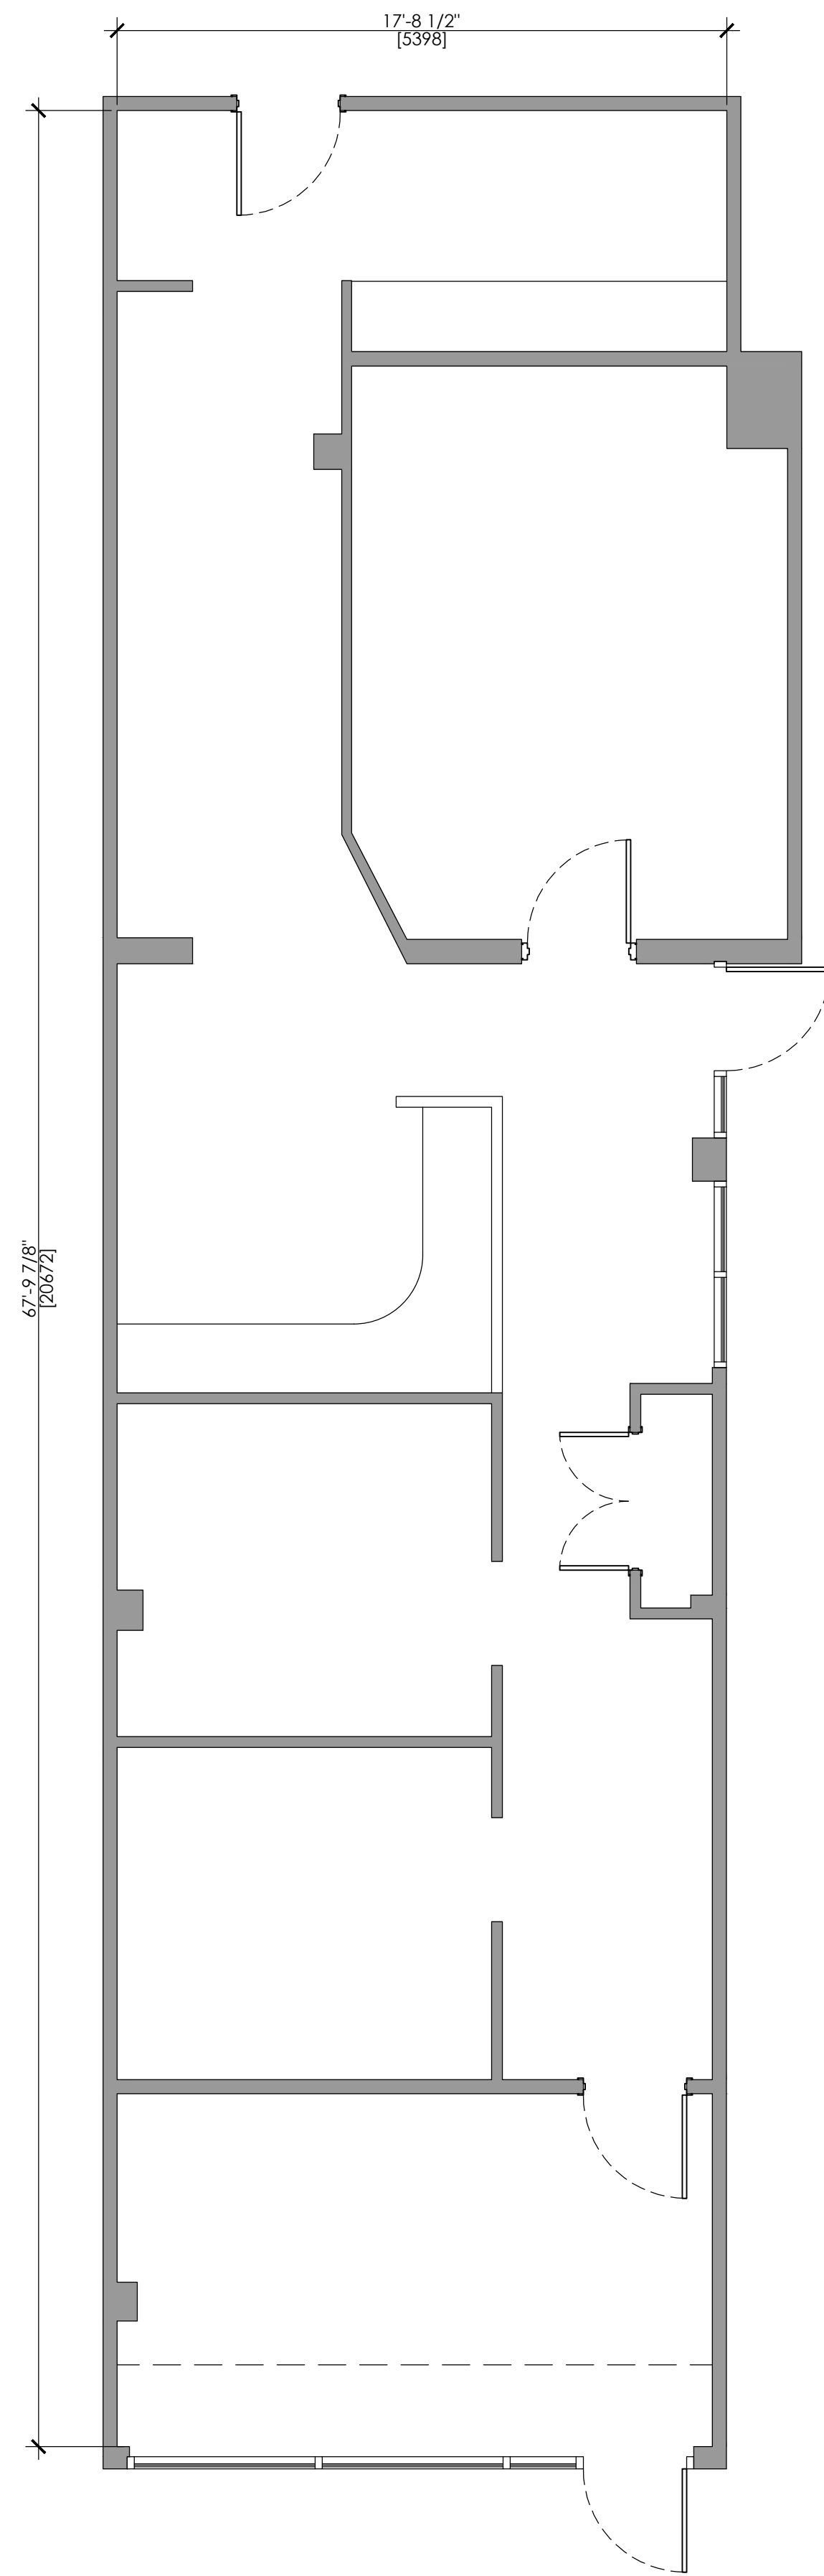

AS-BUILT PLAN  
SCALE: 3/16" = 1'-0" (2001)  
01  
A1.0

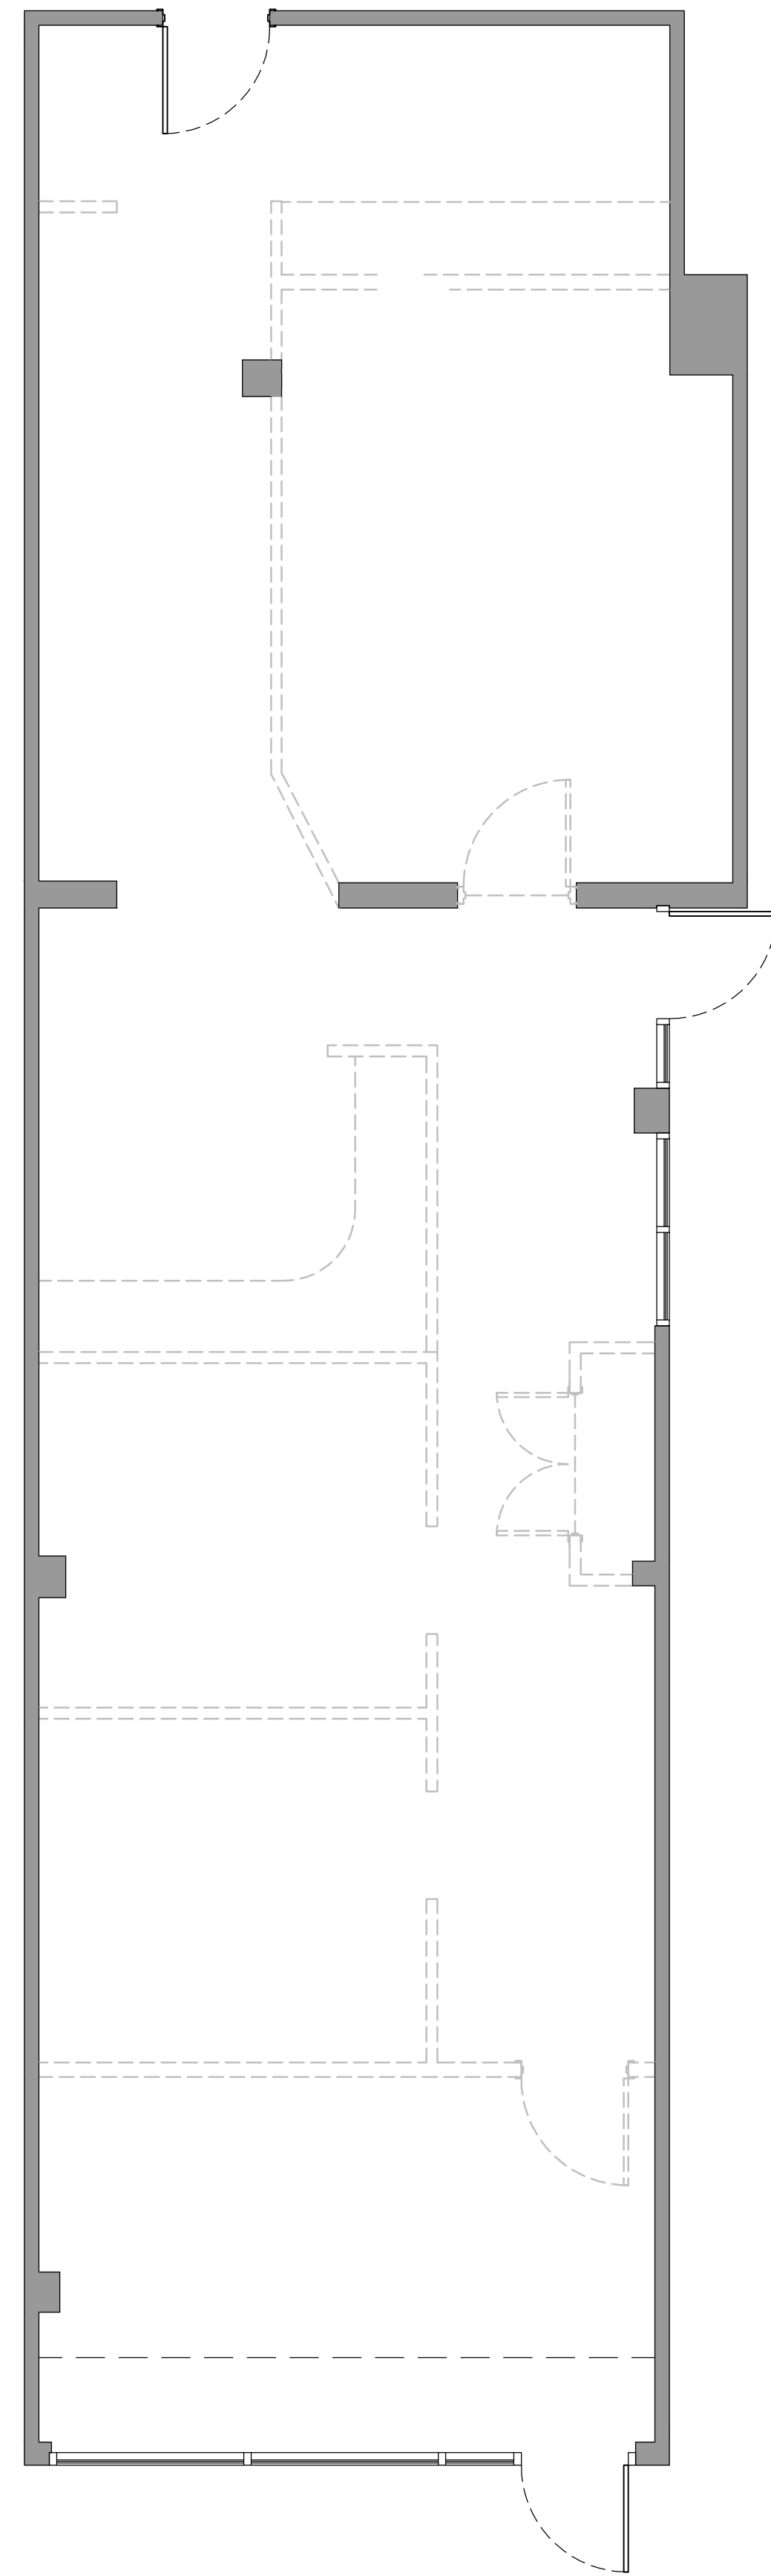


DEMO PLAN  
SCALE: 1/4" = 1'-0" (2001)  
02  
A1.0

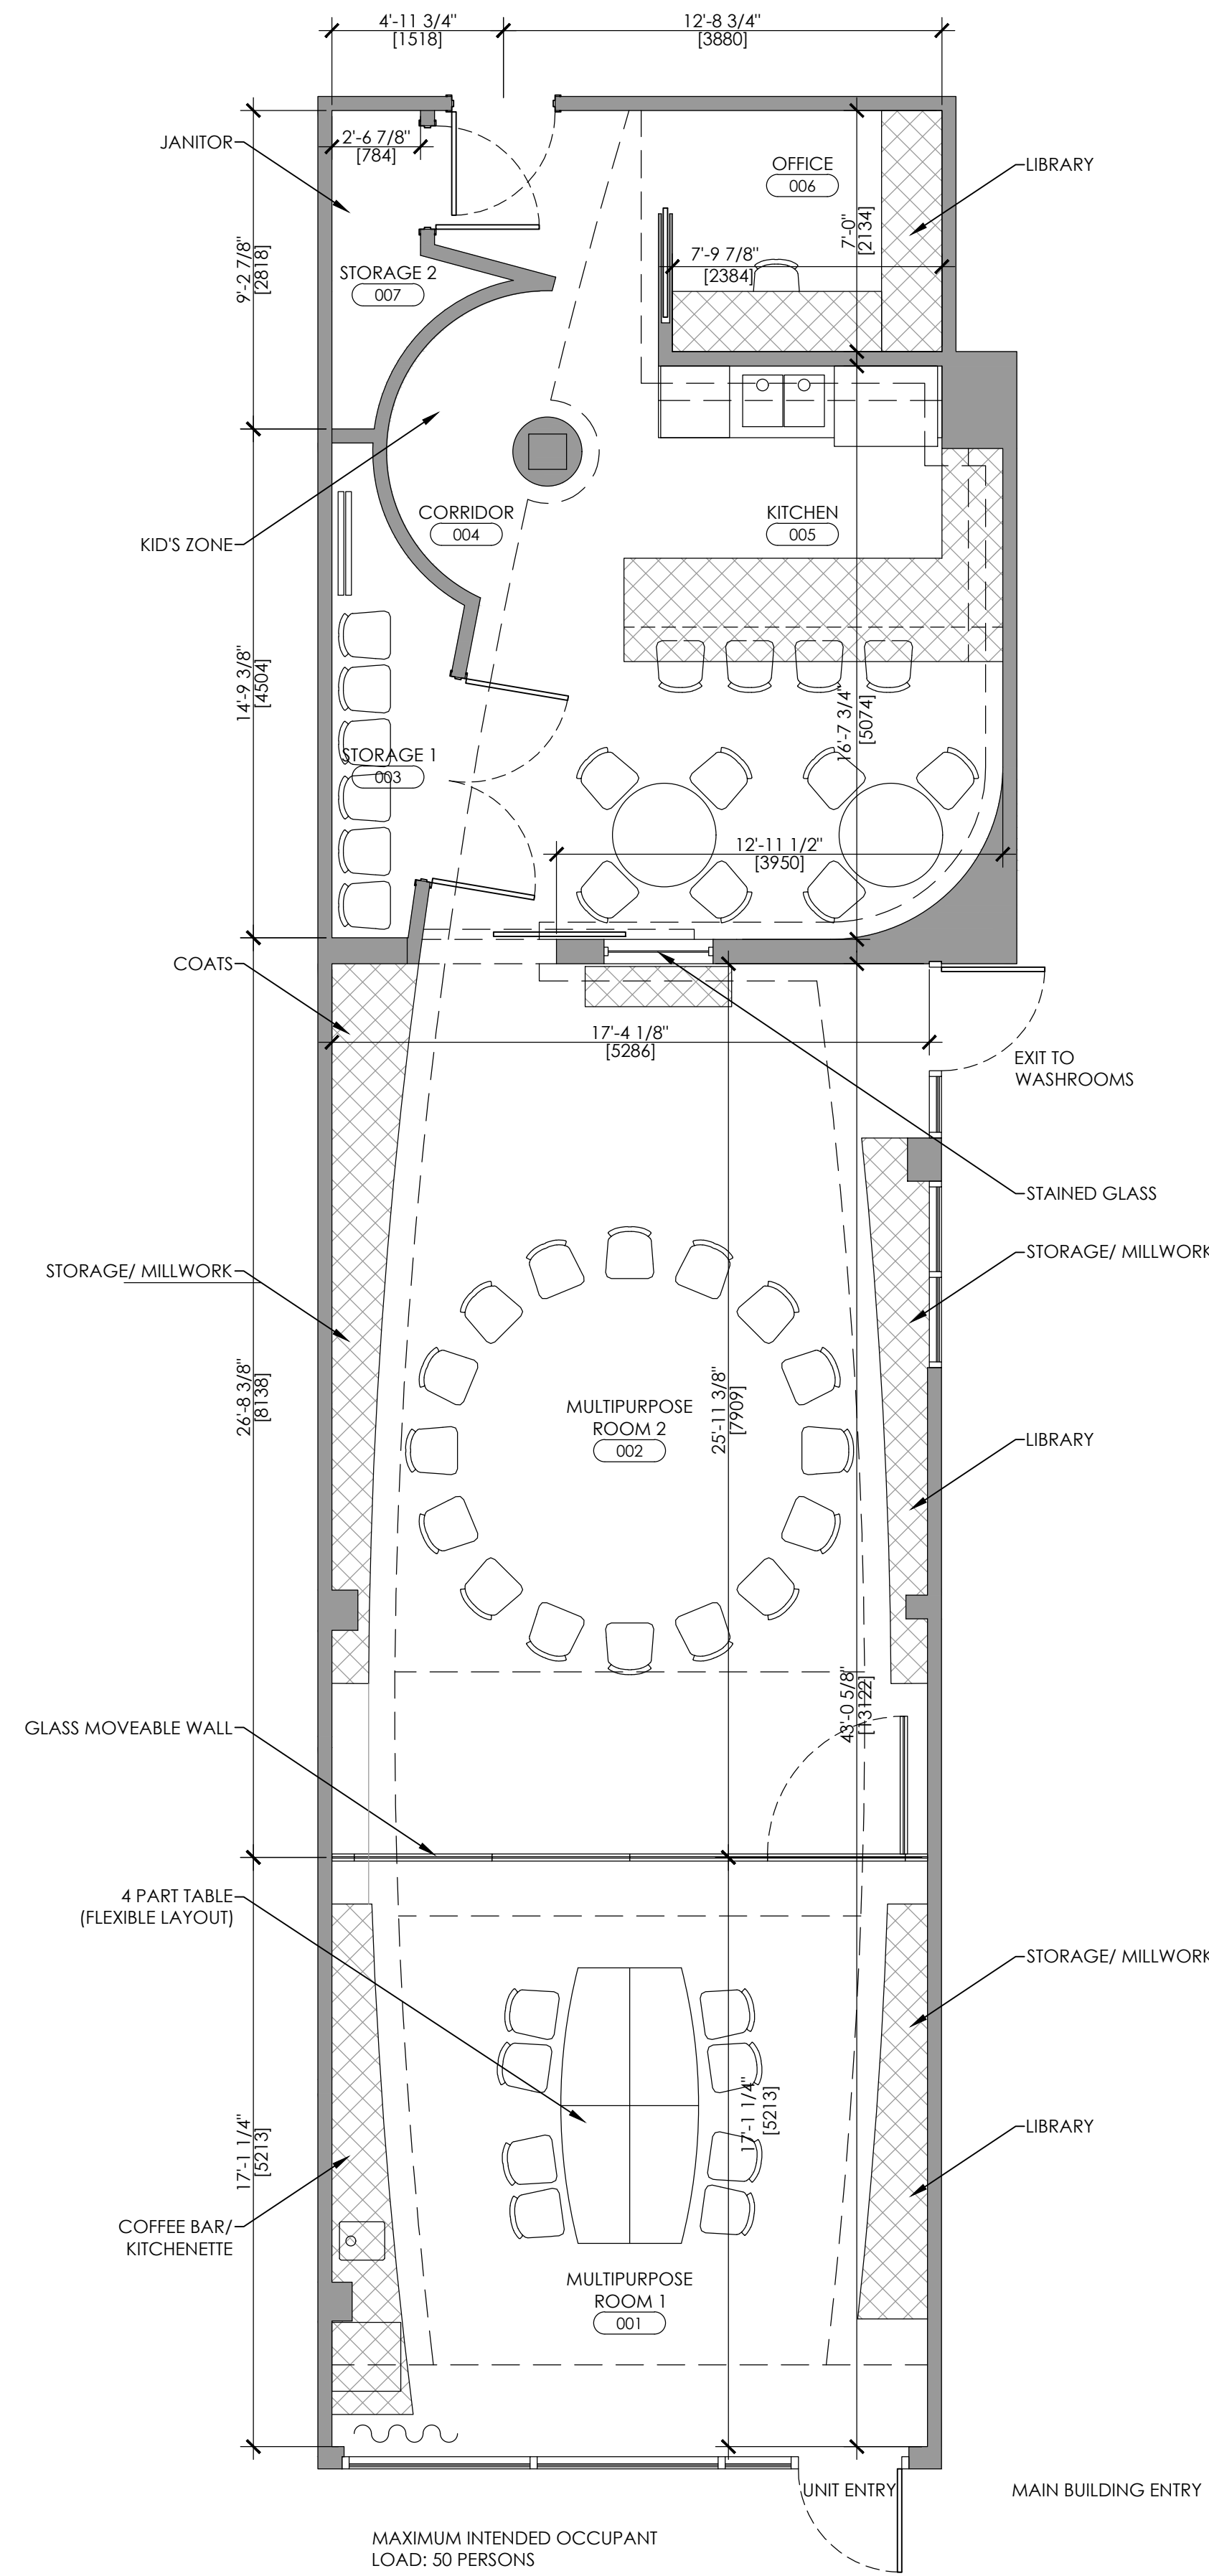

MAXIMUM INTENDED OCCUPANT LOAD: 50 PERSONS  
NON-FIXED SEATING COUNT: 50

CONFIGURATION A (CLASSES)  
PROPOSED PLAN  
SCALE: 3/16" = 1'-0" (2001)  
03  
A1.0

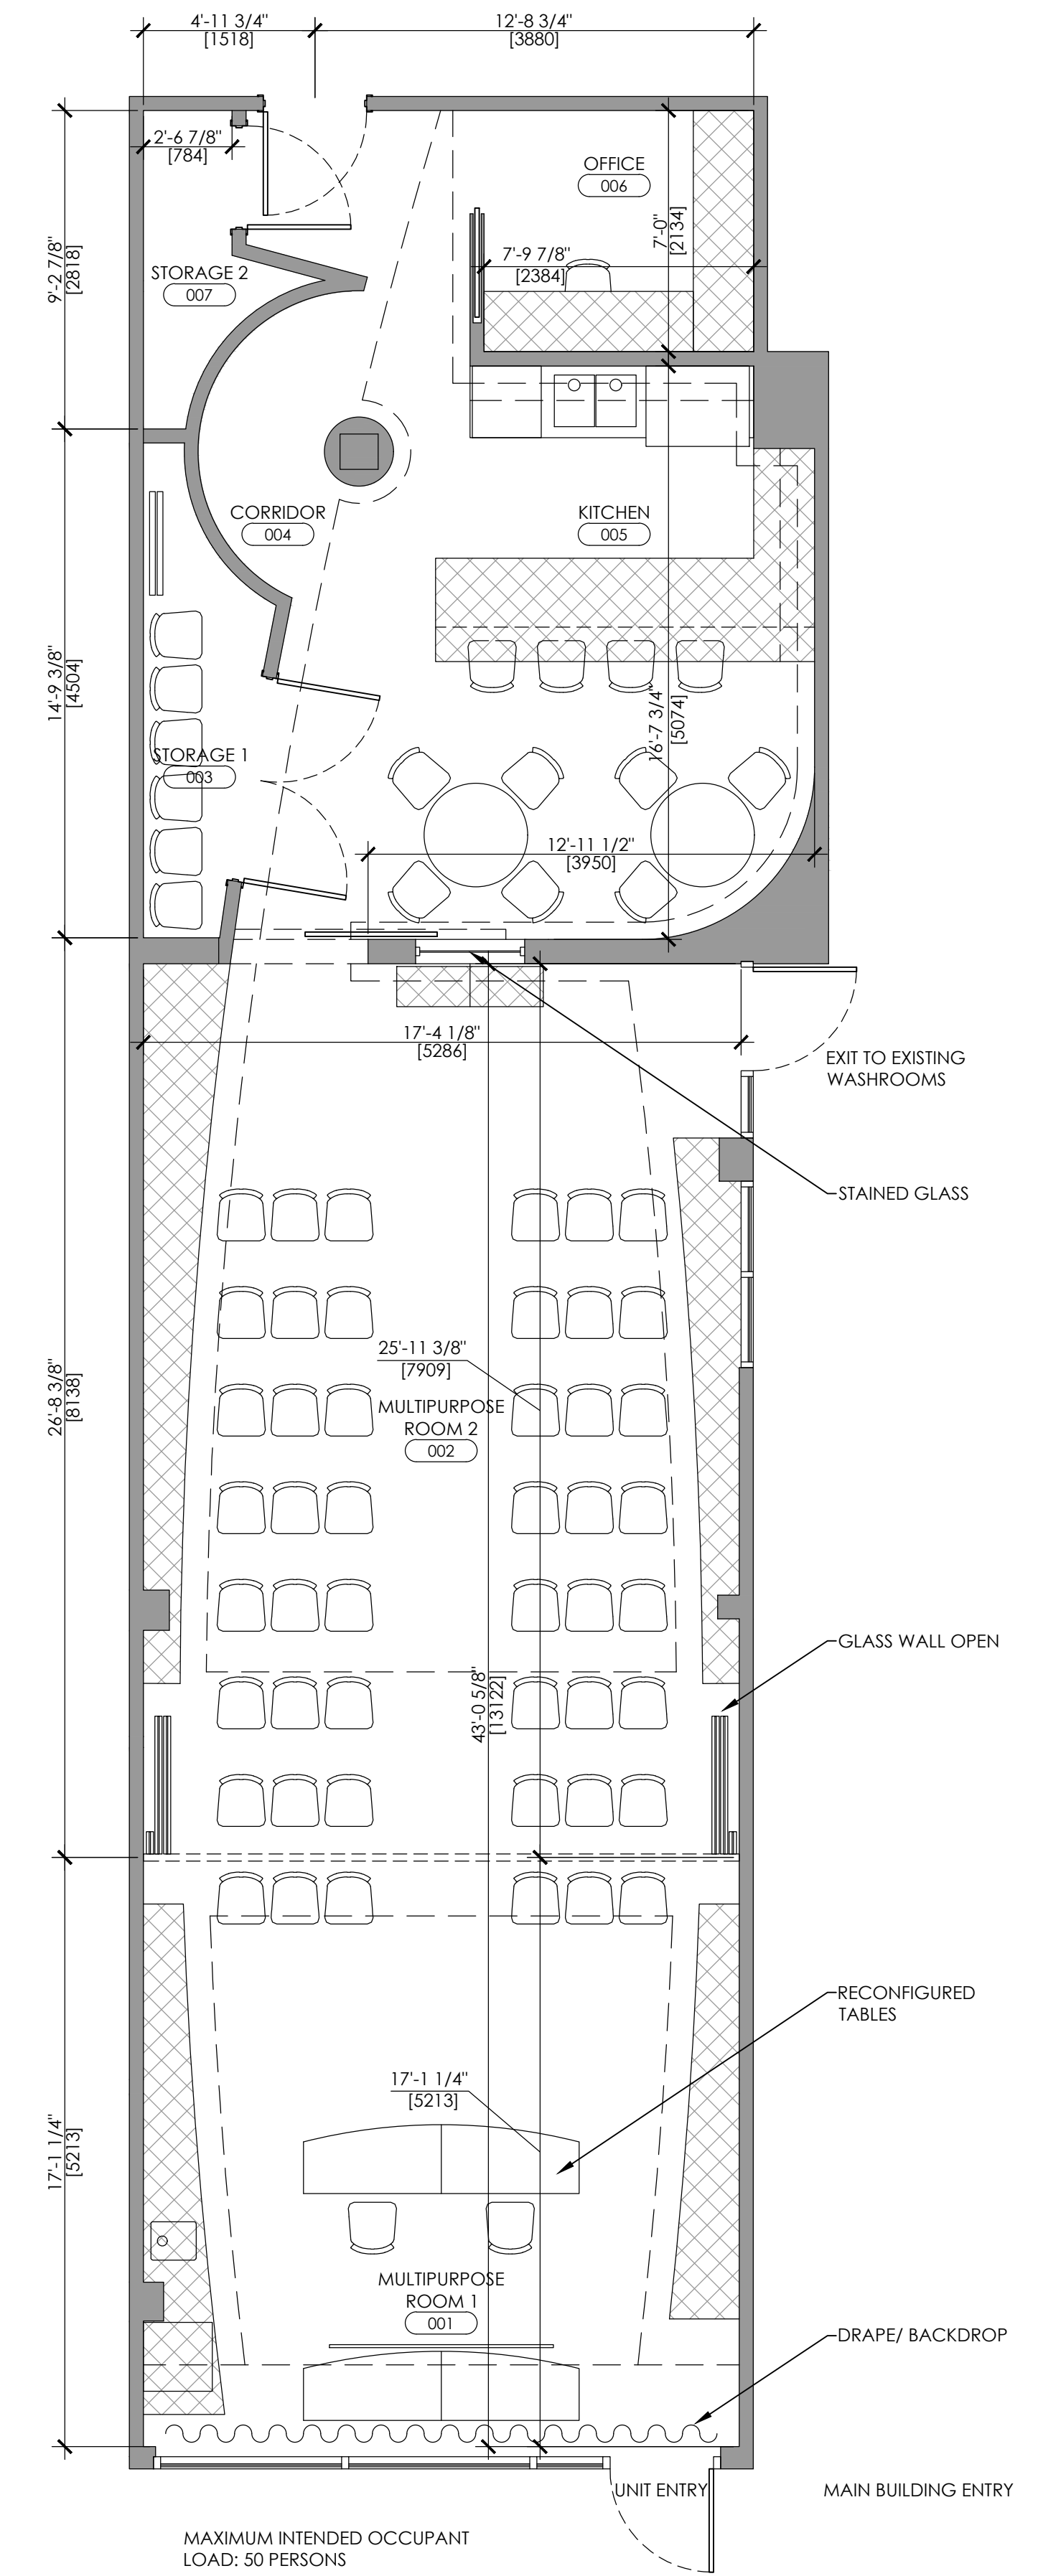

MAXIMUM INTENDED OCCUPANT LOAD: 50 PERSONS  
NON-FIXED SEATING COUNT: 50

CONFIGURATION B (SERVICE)  
PROPOSED PLAN  
SCALE: 3/16" = 1'-0" (2001)  
04  
A1.0

NOT FOR CONSTRUCTION

1204 12 STREET S.W.  
CALGARY, ALBERTA,  
CANADA  
T3C 1A9  
p: 403.270.9376  
e: robert@rparch.ca

ISSUE/REVISION:	DATE	DESCRIPTION
20.08.28	20.08.28	ISSUED FOR CLIENT INFO
-	-	-
-	-	-
JOB TITLE:  
COMMUNITY OF CHRIST  
Value  
422 11 AVE SE  
CALGARY, AB  
T2G 0Y4

JOB #:	DATE:	20.08.28
2001	SCALE:	AS SHOWN
	DESIGN BY:	RPA
	DRAWN BY:	FA

DRAWING TITLE:  
MAIN FLOOR PLAN